

**AS-BUILT GROUND FLOOR FRAMING PLAN**  
 SCALE: 1:100MM

LEGEND:  
 ■ CONTINUOUS COLUMN

PREPARED BY  
**MARIE KAREN B. MANAÑO**  
 ARCHITECT

OWNER  
**SOCIAL SECURITY SYSTEM (SSS)**  
 EAST AVENUE, DUMALAO, QUEZON CITY

PROJECT TITLE/LOCATION  
**STRUCTURAL ASSESSMENT OF SSS CAGAYAN DE ORO BUILDING**  
 CARMEN PANG ROAD, CARMEN, CAGAYAN DE ORO CITY


SHEET CONTENTS  
**AS-BUILT GROUND FLOOR FRAMING PLAN**

REMARKS: R.A. 9298 SEC. 33  
 DENYING AND SUSPENDING AND REVOKING OF PROFESSIONAL REGISTRATION OF ARCHITECTS AND ENGINEERS. THE ARCHITECTS AND ENGINEERS ARE NOT TO BE HELD RESPONSIBLE FOR THE DESIGN OR CONSTRUCTION OF THE PROJECT FOR WHICH THEY ARE NOT REGISTERED OR REGISTERED IN THE ARCHITECTURAL BOARD OF THE PHILIPPINES. THE ARCHITECTS AND ENGINEERS ARE NOT TO BE HELD RESPONSIBLE FOR THE DESIGN OR CONSTRUCTION OF THE PROJECT FOR WHICH THEY ARE REGISTERED OR REGISTERED IN THE ARCHITECTURAL BOARD OF THE PHILIPPINES. THE ARCHITECTS AND ENGINEERS ARE NOT TO BE HELD RESPONSIBLE FOR THE DESIGN OR CONSTRUCTION OF THE PROJECT FOR WHICH THEY ARE REGISTERED OR REGISTERED IN THE ARCHITECTURAL BOARD OF THE PHILIPPINES.

DATE	NO.	REVISIONS
OCT 2018	0	

DATE	NO.	REVISIONS	CHECK	DATE	PAPER SIZE	SHEET NO.
OCT 2018	0				20X30	S-001
OCT 2018					SCALE	PROJECT NO.
OCT 2018					AS SHOWN	SO-G-18-018




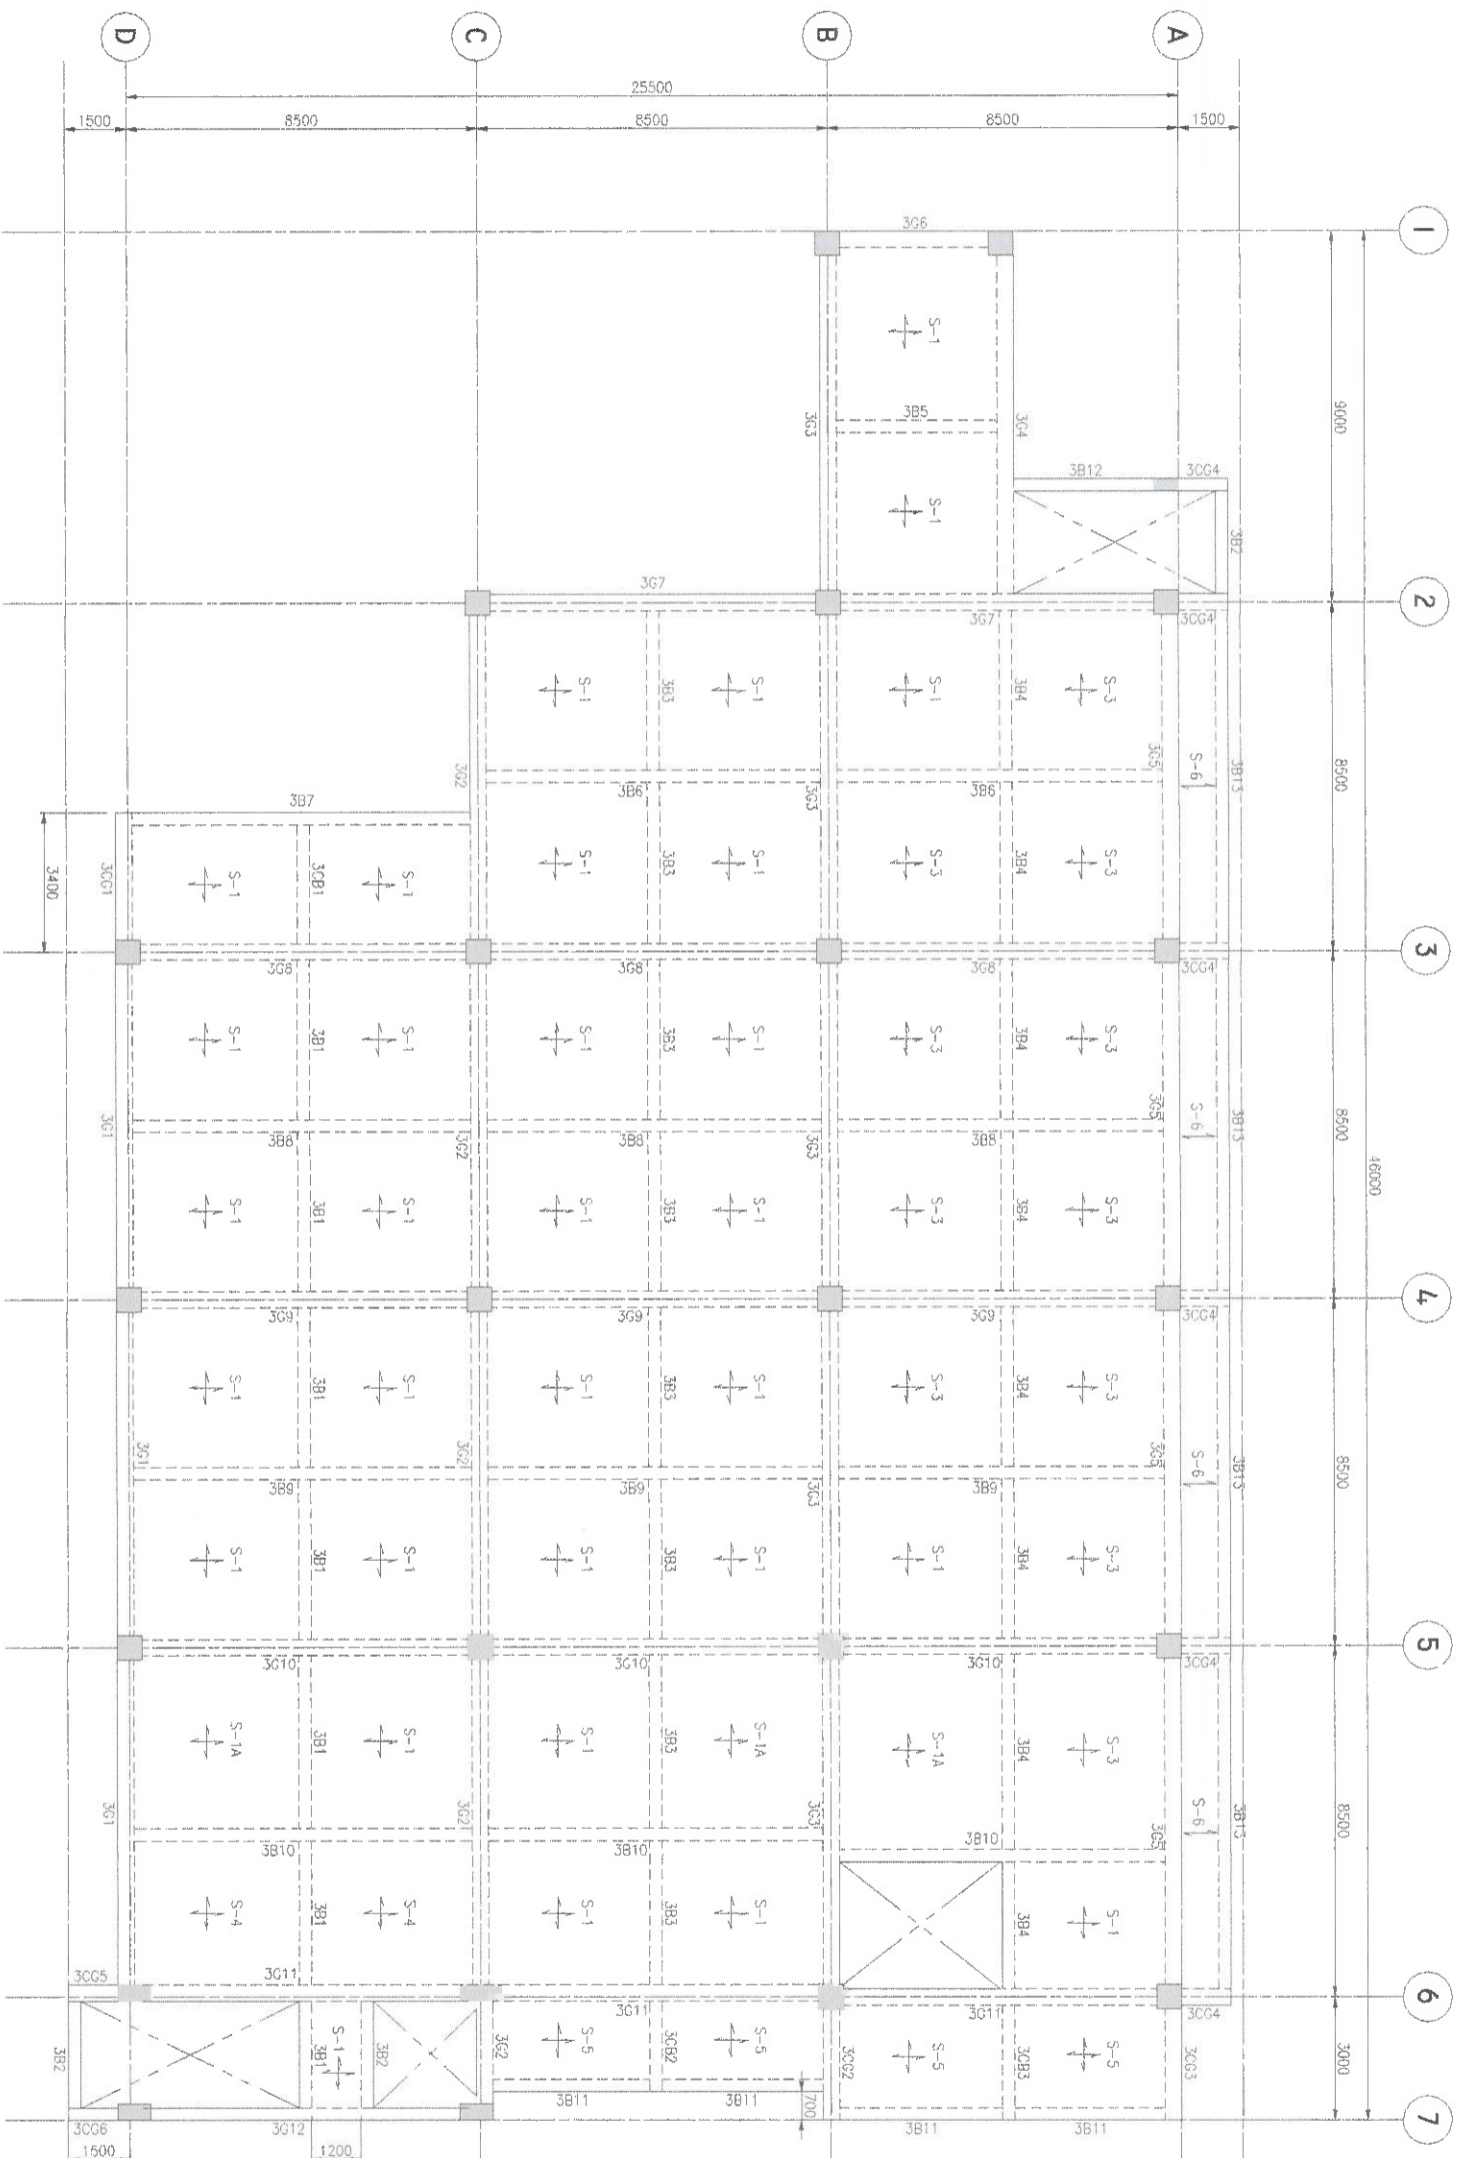

**AS-BUILT**  
**THIRD FLOOR FRAMING PLAN**  
 SCALE: 1:100MM

LEGEND:  
 ■ - CONTINUOUS COLUMN


PREPARED BY:  <b>MAE KAREN B. MANAGO</b> ENGINEER	OWNER: <b>SOCIAL SECURITY SYSTEM (SSS)</b> EAST AVENUE, DIZAM, QUEZON CITY	PROJECT TITLE/LOCATION: <b>STRUCTURAL ASSESSMENT OF SSS CAGAYAN DE ORO BUILDING</b> CAGAYAN PATAK ROAD, CAGAYAN, CAGAYAN DE ORO CITY	SHEET CONTENTS: <b>AS-BUILT THIRD FLOOR FRAMING PLAN</b>
RA 9786 SEC. 33 DRAWINGS AND SPECIFICATIONS ARE CONTRACT DOCUMENTS AND SHALL BE USED AS SUCH. THE CONTRACTOR SHALL BE RESPONSIBLE FOR THE PROPER INTERPRETATION AND CONSTRUCTION THEREOF. ANY CHANGES TO THE DRAWINGS SHALL BE MADE IN WRITING AND APPROVED BY THE ARCHITECT. THE CONTRACTOR SHALL BE RESPONSIBLE FOR THE PROPER CONSTRUCTION AND MAINTENANCE OF THE WORK. THE ARCHITECT SHALL BE RESPONSIBLE FOR THE DESIGN AND CONSTRUCTION OF THE WORK.			
CHECKED BY: HMC	DATE: OCT 2018	NO.: 0	REVISIONS:
CHECKED BY: JMBP	DATE: OCT 2018	NO.: 0	REVISIONS:
CHECKED BY: ACO	DATE: OCT 2018	NO.: 0	REVISIONS:
PAPER SIZE: <b>20X30</b>	SHEET NO.: <b>S-003</b>	PROJECT NO.: <b>SO-G-18-018</b>	SCALE: <b>AS SHOWN</b>

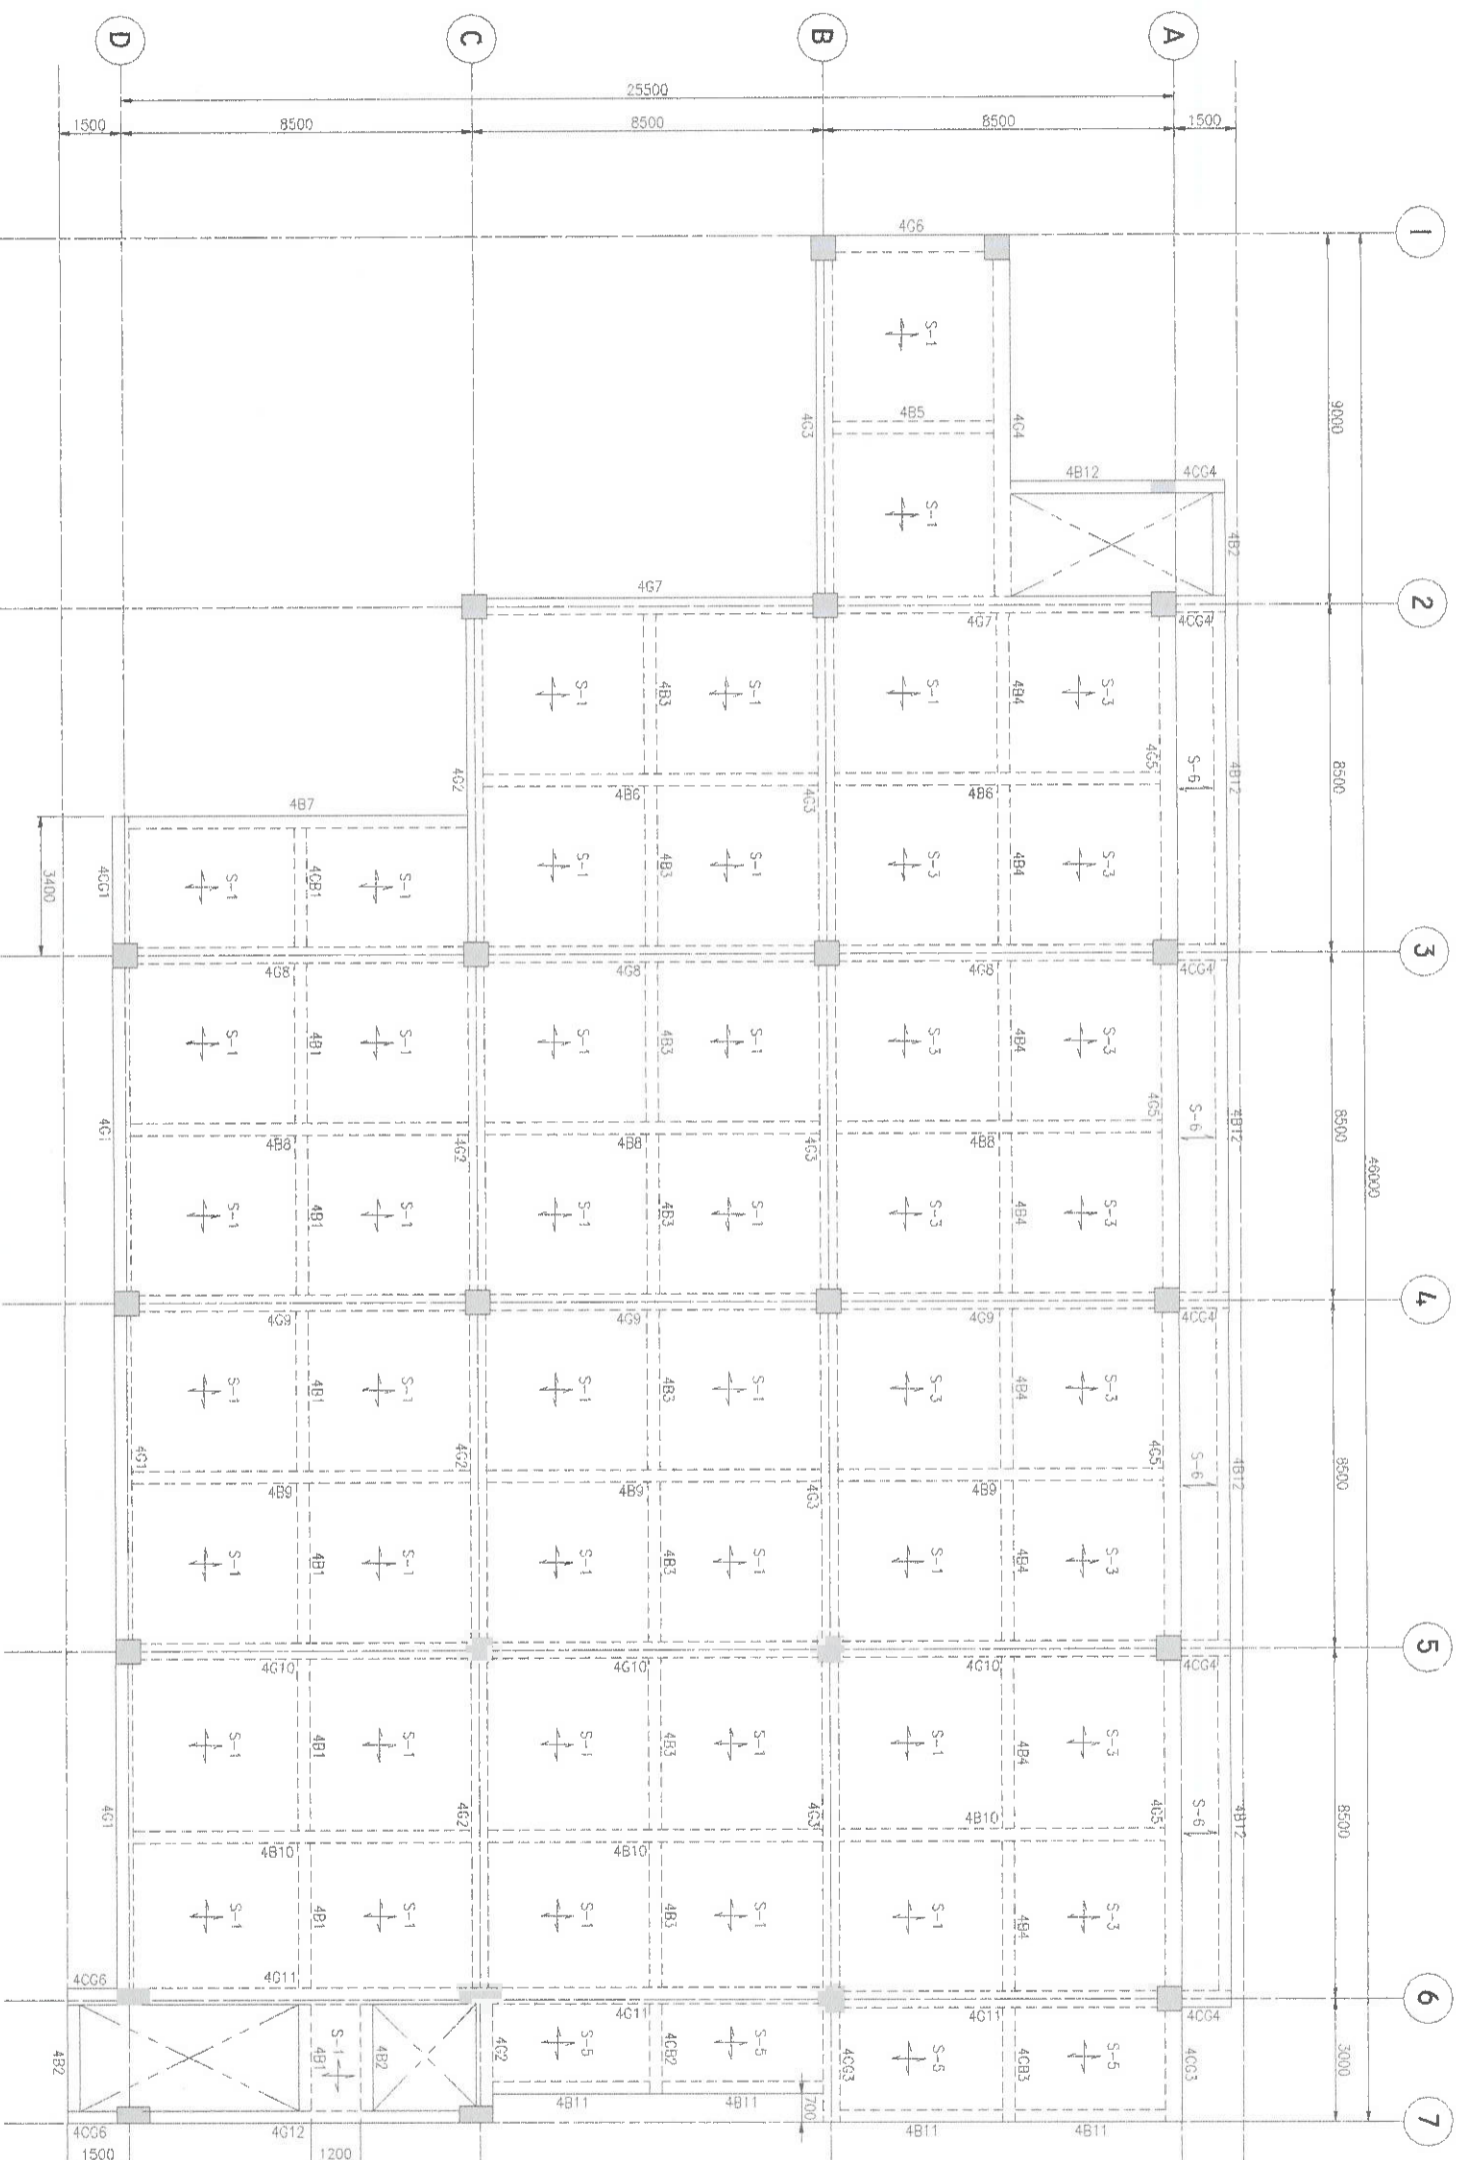

**AS-BUILT  
FOURTH FLOOR FRAMING PLAN**  
S-004 SCALE 1:100M

LEGEND :  
 CONTINUOUS COLUMN

PREPARED BY <i>Mae Karen B. Manago</i> ENGINEER	OWNER <b>SOCIAL SECURITY SYSTEM (SSS)</b> DOST AGENCIE, DAVAO, QUEZON CITY	PROJECT TITLE/LOCATION <b>STRUCTURAL ASSESSMENT OF SSS CAGAYAN DE ORO BUILDING</b> ORIENT PRIMA ROAD, CAGAYAN DE ORO CITY	SHEET CONTENTS <b>FOURTH FLOOR FRAMING PLAN (SHOWING SAMPLING POINTS)</b>	REVISIONS DATE: OCT 2018 BY: JMB APPROVED: [Signature] DATE: OCT 2018 BY: JMB	NO. OF REVISIONS 0	CHK. DATE	PAPER SIZE <b>20X30</b>	SHEET NO. <b>S-004</b>
PROJECT NO. <b>SO-G-18-018</b>								

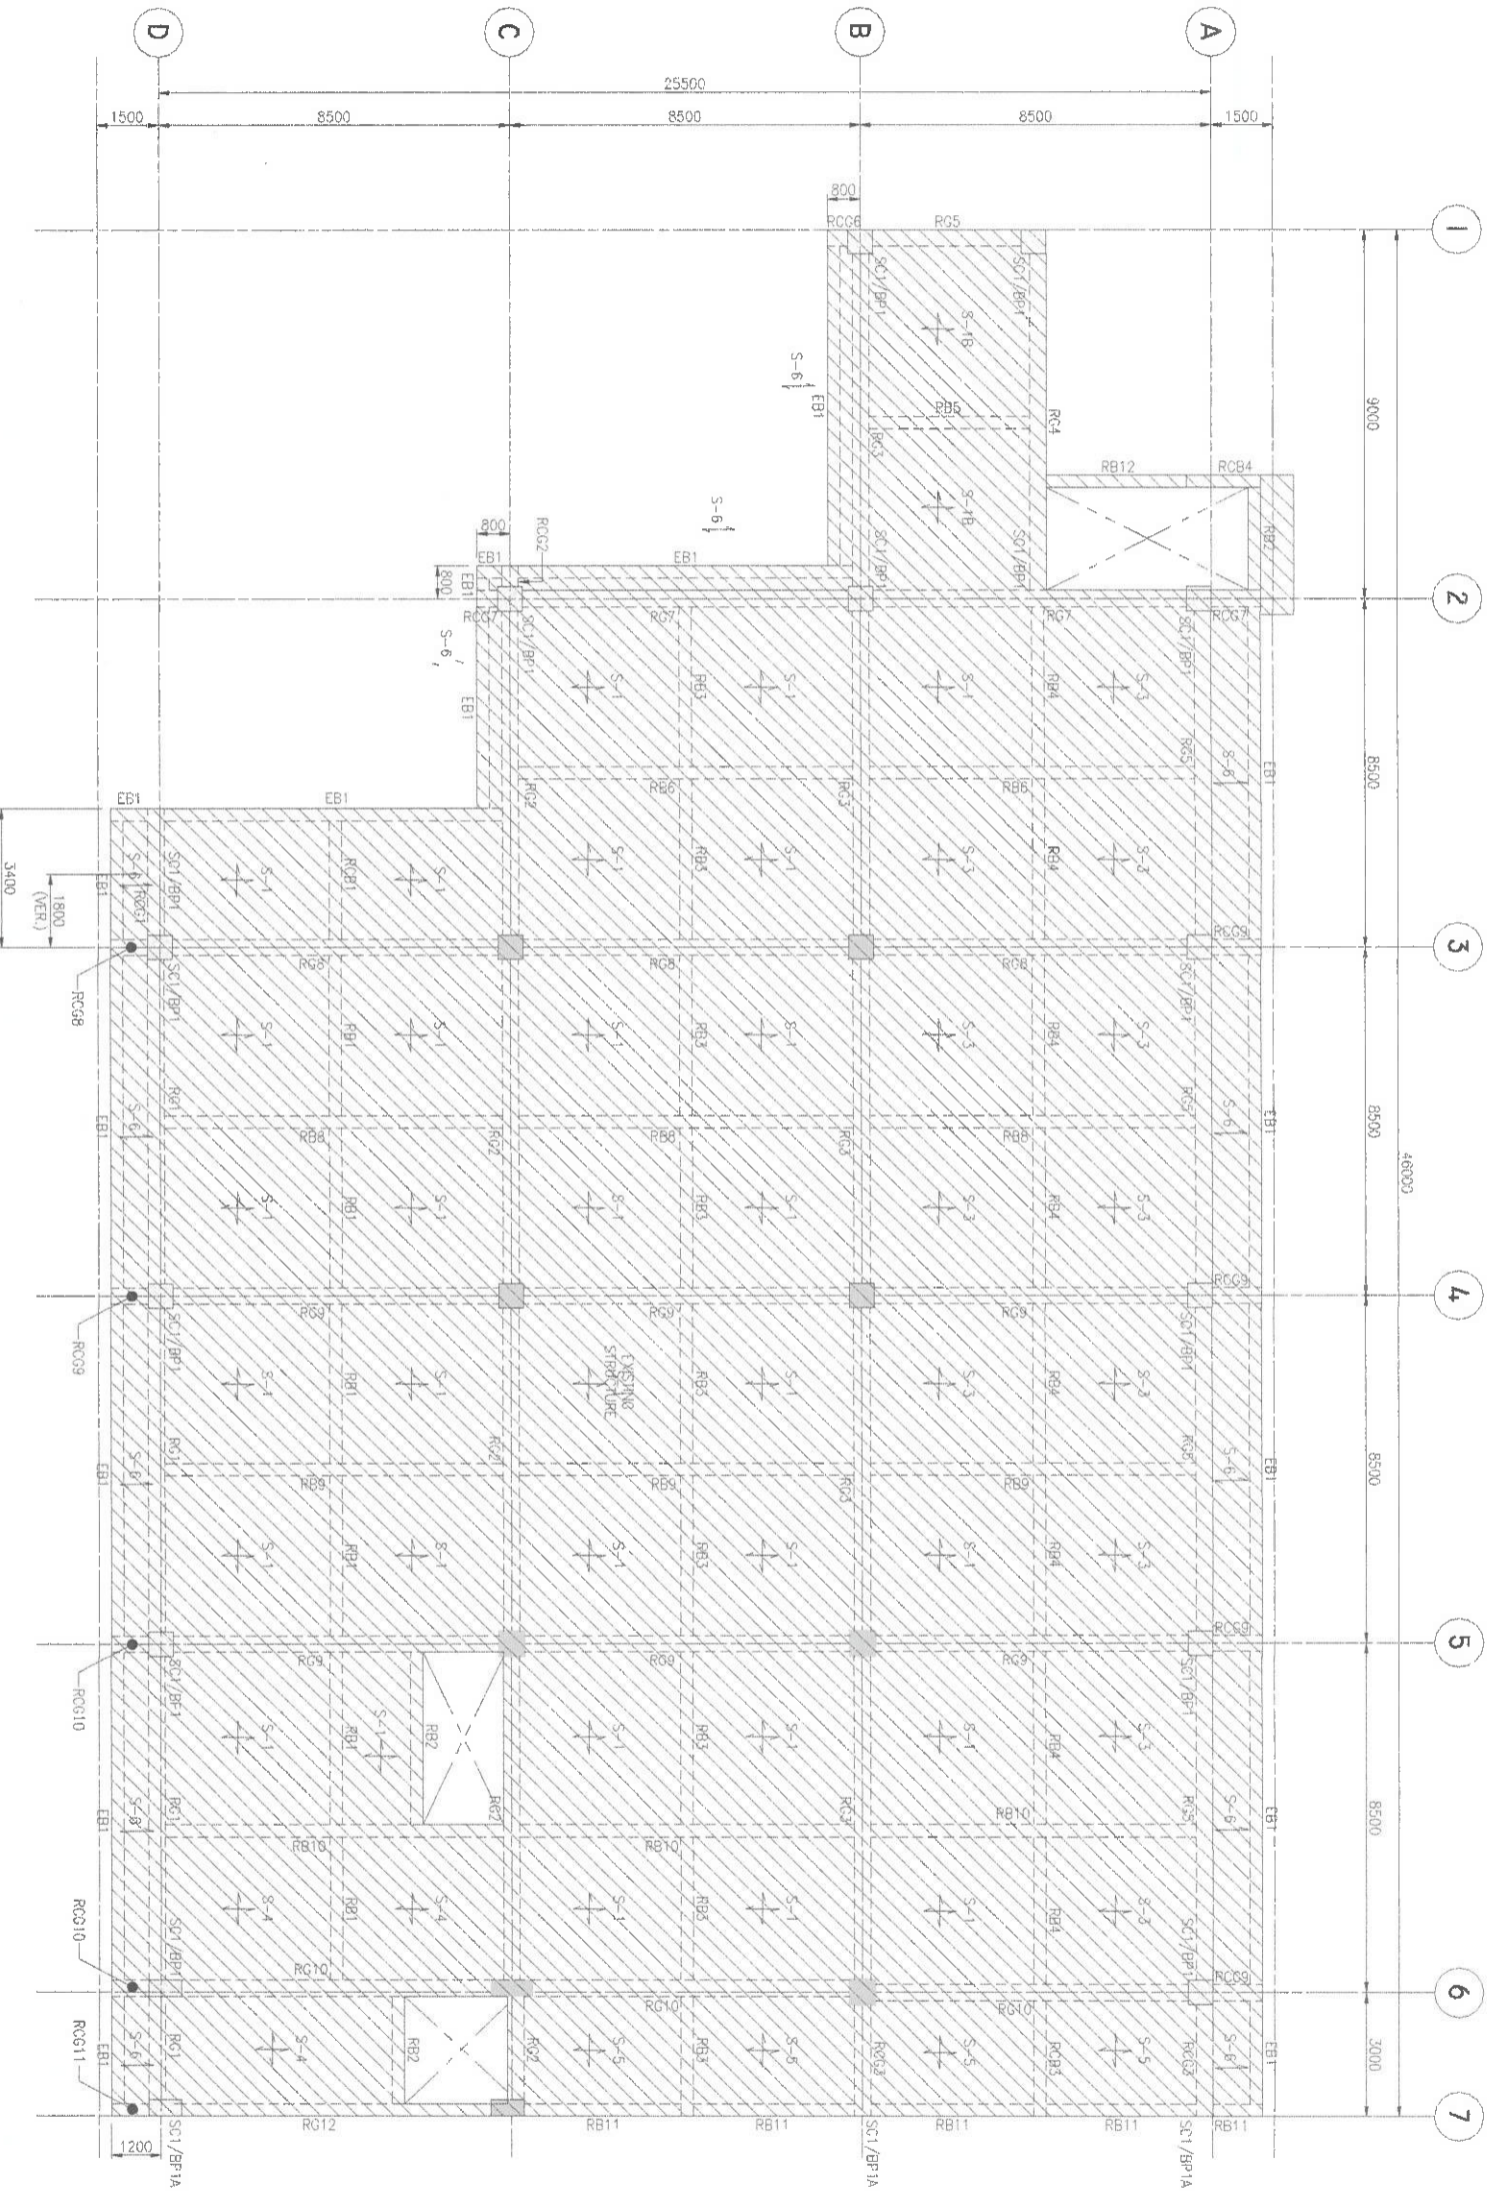

**AS-BUILT ROOF DECK FRAMING PLAN**  
 SCALE 1:100M

LEGEND:  
 ■ - CONTINUOUS COLUMN  
 ▨ - TERMINATED COLUMN

PREPARED BY  
**MAE KAREN B. MANAGO**  
 ENGINEER


OWNER  
**SOCIAL SECURITY SYSTEM (SSS)**  
 EAST AVENUE, DIZAM, DUEZON CITY

PROJECT TITLE/LOCATION  
**STRUCTURAL ASSESSMENT OF SSS CAGAYAN DE ORO BUILDING**  
 CARMEN PARK ROAD, CARMEN, CAGAYAN DE ORO CITY

SHEET CONTENTS  
**AS-BUILT ROOF DECK FRAMING PLAN**

P.A. 9266 SEC. 33  
 ISSUANCE AND SPECIFICATIONS AND GOVERNING REGULATIONS FOR THE DESIGN AND CONSTRUCTION OF STRUCTURES FOR SERVICE ARE THE RESPONSIBILITY OF THE DESIGNER. THE ENGINEER HAS NOT CONDUCTED VISUAL INSPECTION OF THE EXISTING STRUCTURE OR THE FOUNDATION. THE USER OF THIS DRAWING SHALL BE RESPONSIBLE FOR THE VERIFICATION OF THE EXISTING STRUCTURE AND FOUNDATION. THE ENGINEER'S LIABILITY IS LIMITED TO THE DESIGN AND CONSTRUCTION OF THE STRUCTURE AS SHOWN ON THIS DRAWING.

DATE	NO.	REVISIONS	CHK.	DATE	PAPER SIZE	SHEET NO.
OCT 2018	HAE				20X30	S-005
OCT 2018	DESIGNED				SCALE	PROJECT NO.
OCT 2018	CHKD				AS SHOWN	SO-G-18-018
OCT 2018	APPROVED					
OCT 2018	ACD					

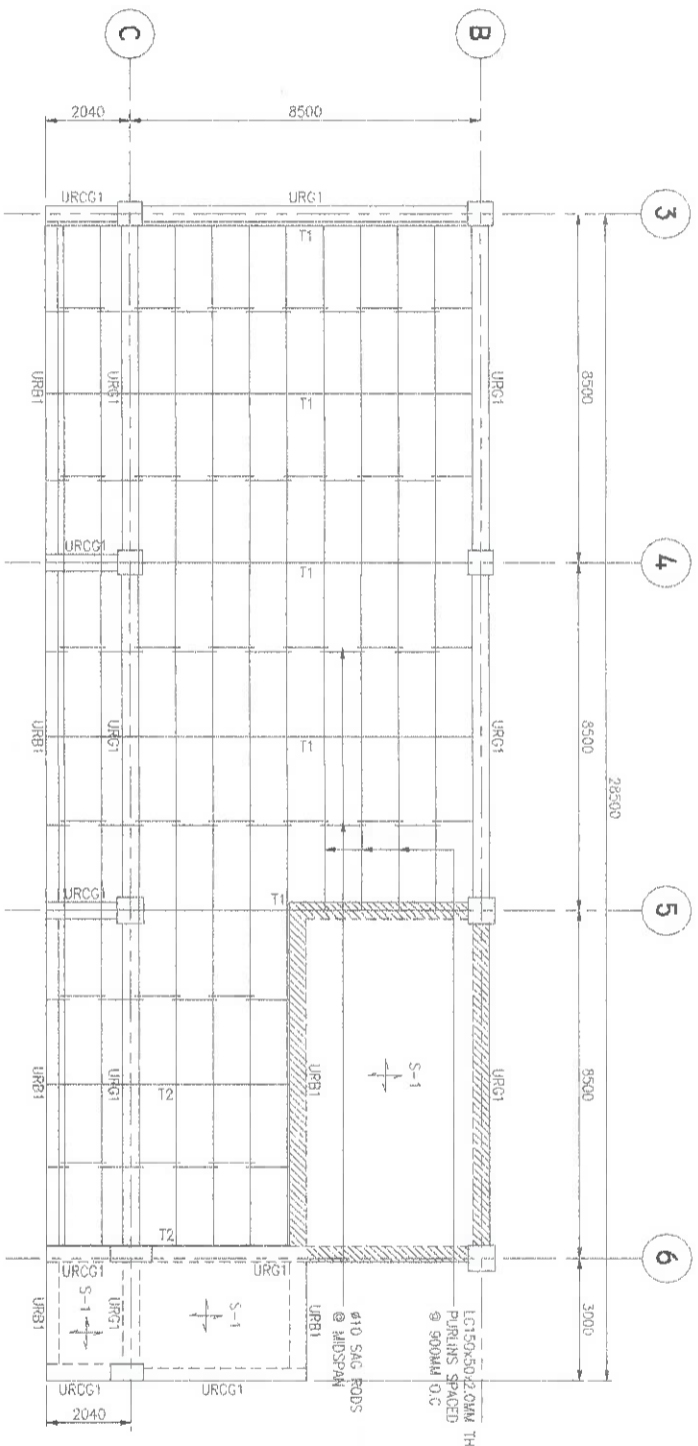

**1** AS-BUILT UPPER ROOF DECK LEVEL  
SCALE 1:100M




LEGEND:  
- TERMINATED COLUMN

**SCHEDULE OF COLUMNS**

FLOOR LEVEL	COL. MARK	COL. CI	COL. C2	COL. C3	COL. C4	COL. C5	COL. C6	COL. C7	COL. C8	COL. C9	COL. C10	COL. C11
GROUND TO ROOF	CC1	CI	C2	C3	C4	C5	C6	C7	C8	C9	C10	C11
SIZE (mm)	450x450	600x600	600x600	400x900	400x800	600x600	600x600	600x600	400x1000	600x600	600x600	300x600
VERT. REINF.	4-#20	28-#28	28-#25	24-#25	20-#25	20-#25	20-#28	20-#32	28-#28	16-#25	16-#25	10-#25
TIES	Ø12@150	Ø12@150	Ø12@150	Ø12@150	Ø12@150	Ø12@150	Ø12@150	Ø12@150	Ø12@150	Ø12@150	Ø12@150	Ø12@150

**SCHEDULE OF SLABS**

SLAB MARK	THICKN (MM)	BAR LOCATIO	BAR DIA.	SHORT SPAN	LONG SPAN	REMARKS
S-1	100	TOP	Ø12	200	200	TWO WAY
S-2	100	TOP	Ø12	200	200	TWO WAY
S-3	100	TOP	Ø12	200	200	TWO WAY
S-4	100	TOP	Ø12	200	200	TWO WAY
S-5	100	TOP	Ø12	200	200	TWO WAY
S-6	100	TOP	Ø12	200	200	ONE WAY

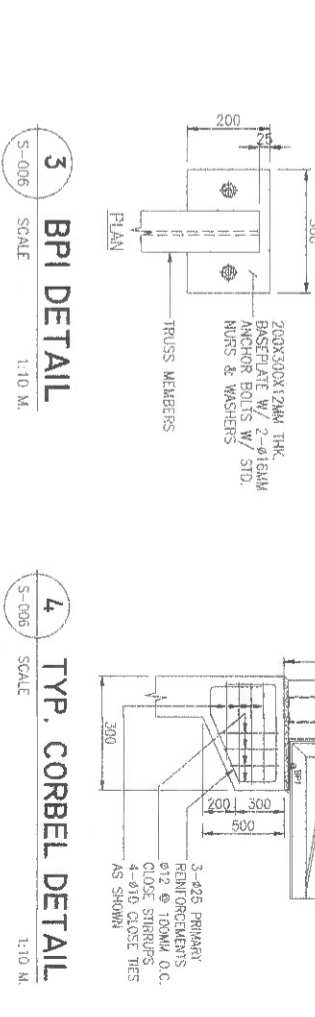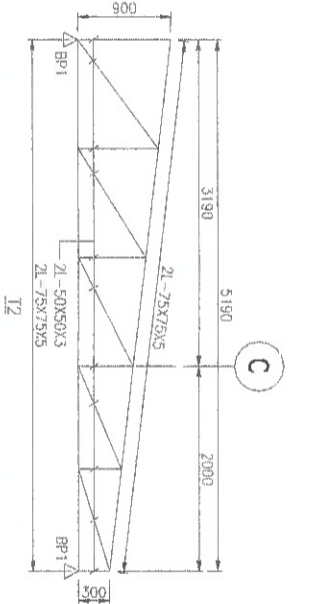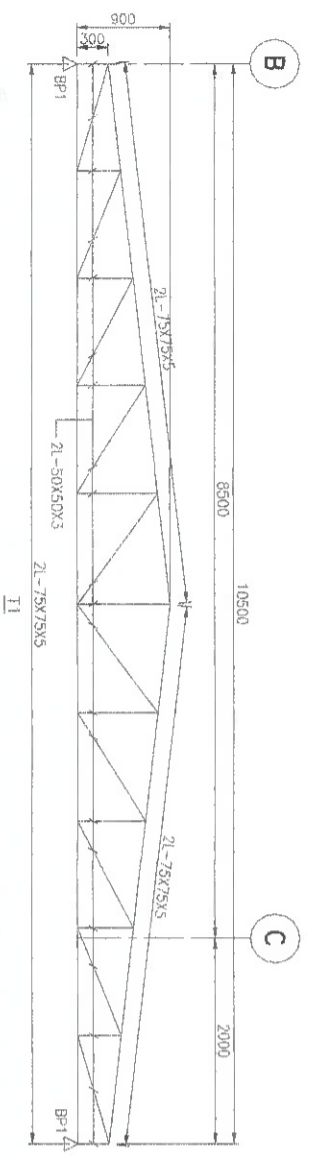

SCHEDULE OF GIRDERS

Table with columns: MARK, SECTION (mm), BAR DIA, LONGITUDINAL BARS (LEFT END, MIDDLE, RIGHT END), WEB BAR EACH, 2H FROM SUPPORT, STRUTUPS, BEYOND 2H, REMARKS. Includes sections for SECOND FLOOR, THIRD FLOOR, and UPPER ROOF DECK.

SCHEDULE OF BEAMS

Table with columns: MARK, SECTION (mm), BAR DIA, LONGITUDINAL BARS (LEFT END, MIDDLE, RIGHT END), WEB BAR EACH, 2H FROM SUPPORT, STRUTUPS, BEYOND 2H, REMARKS. Includes sections for SECOND FLOOR, THIRD FLOOR, and UPPER ROOF DECK.



ENGINEERING + CONSULTING  
ISO 9001:2015  
2118 Lakewood Parkway, Laguna Hills, CA 92653  
Tel: (714) 233-8877 Fax: (714) 233-8878  
Email: info@acconsulting.com

PREPARED BY: MAURICIO B. MARIANO  
OWNER: SOCIAL SECURITY SYSTEM (SSS)  
PROJECT: TITULACION  
ESTR. ADIC. DILMAN, QUEZON CITY  
CARMEN PAVIG ROAD, CARMEN, CAGAYAN BE, GNO CITY

SCHEDULE OF GIRDERS & BEAMS

DESIGNED BY: DATE: OCT 2018  
CHECKED BY: DATE: OCT 2018  
APPROVED BY: DATE: OCT 2018

REVISIONS: NO. DATE DESCRIPTION

PAPER SIZE: 20X30  
SCALE: AS SHOWN  
SHEET NO.: S-007  
PROJECT NO.: SO-G-18-018