



**1**  
AS-BUILT  
FOUNDATION PLAN  
SCALE 1:100M

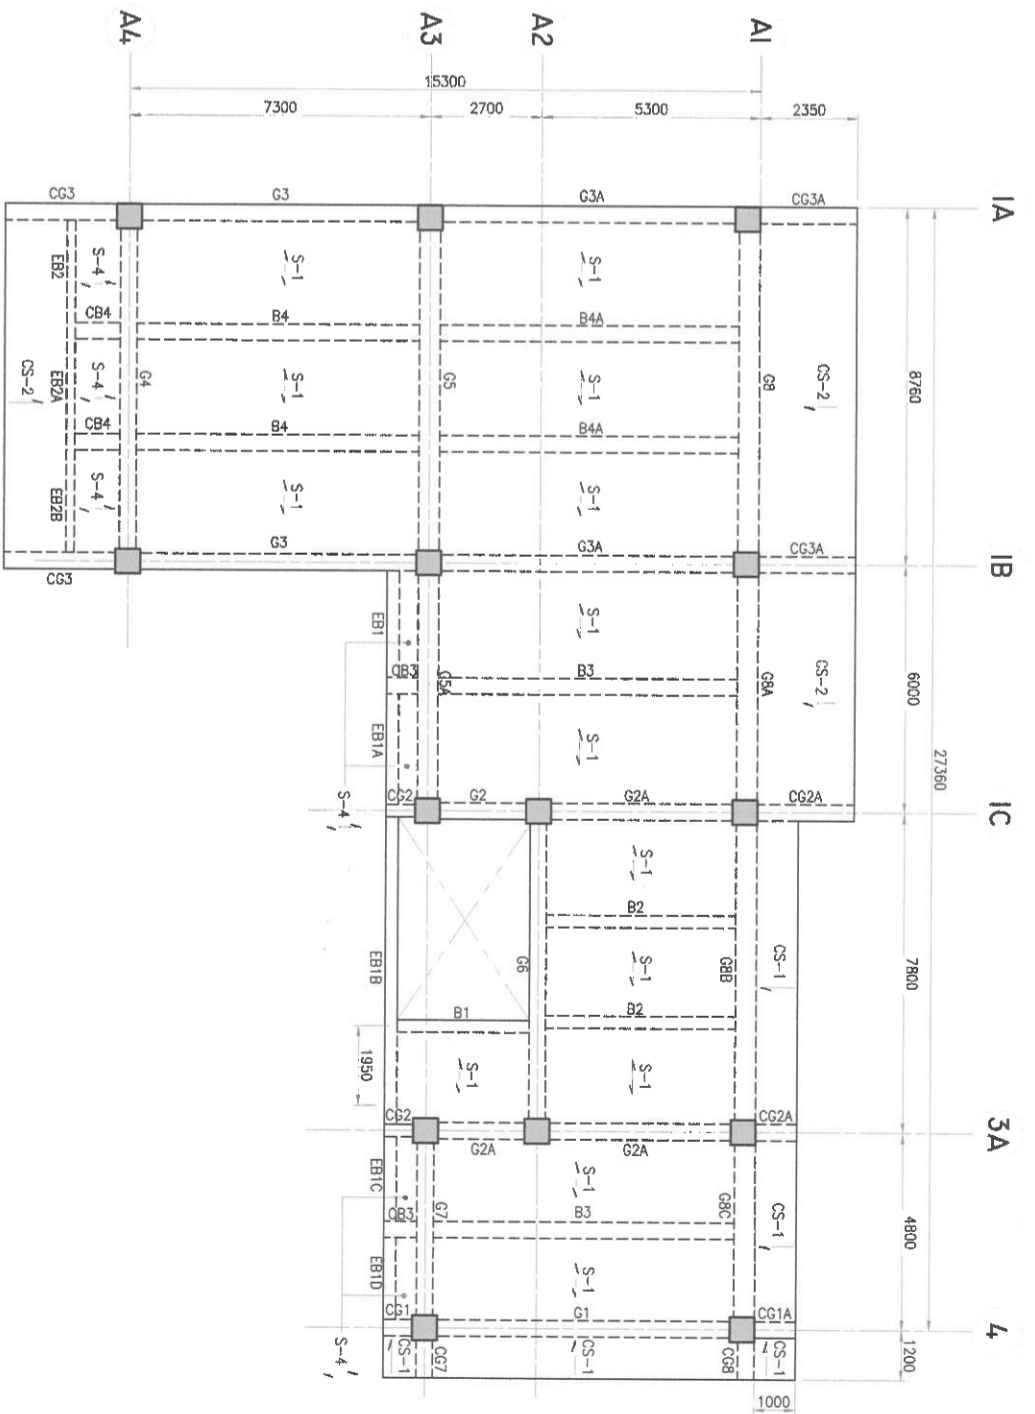


**2**  
AS-BUILT  
GROUND FLOOR FRAMING PLAN  
SCALE 1:100M

LEGEND :  
- CONTINUOUS COLUMN


NO.	DATE	NO.	REVISIONS	CHK.	DATE	PAPER SIZE	SHEET NO.
0	OCT 2018	0				20X30	S-001
						SCALE	PROJECT NO.
						AS SHOWN	SO-G-18-018

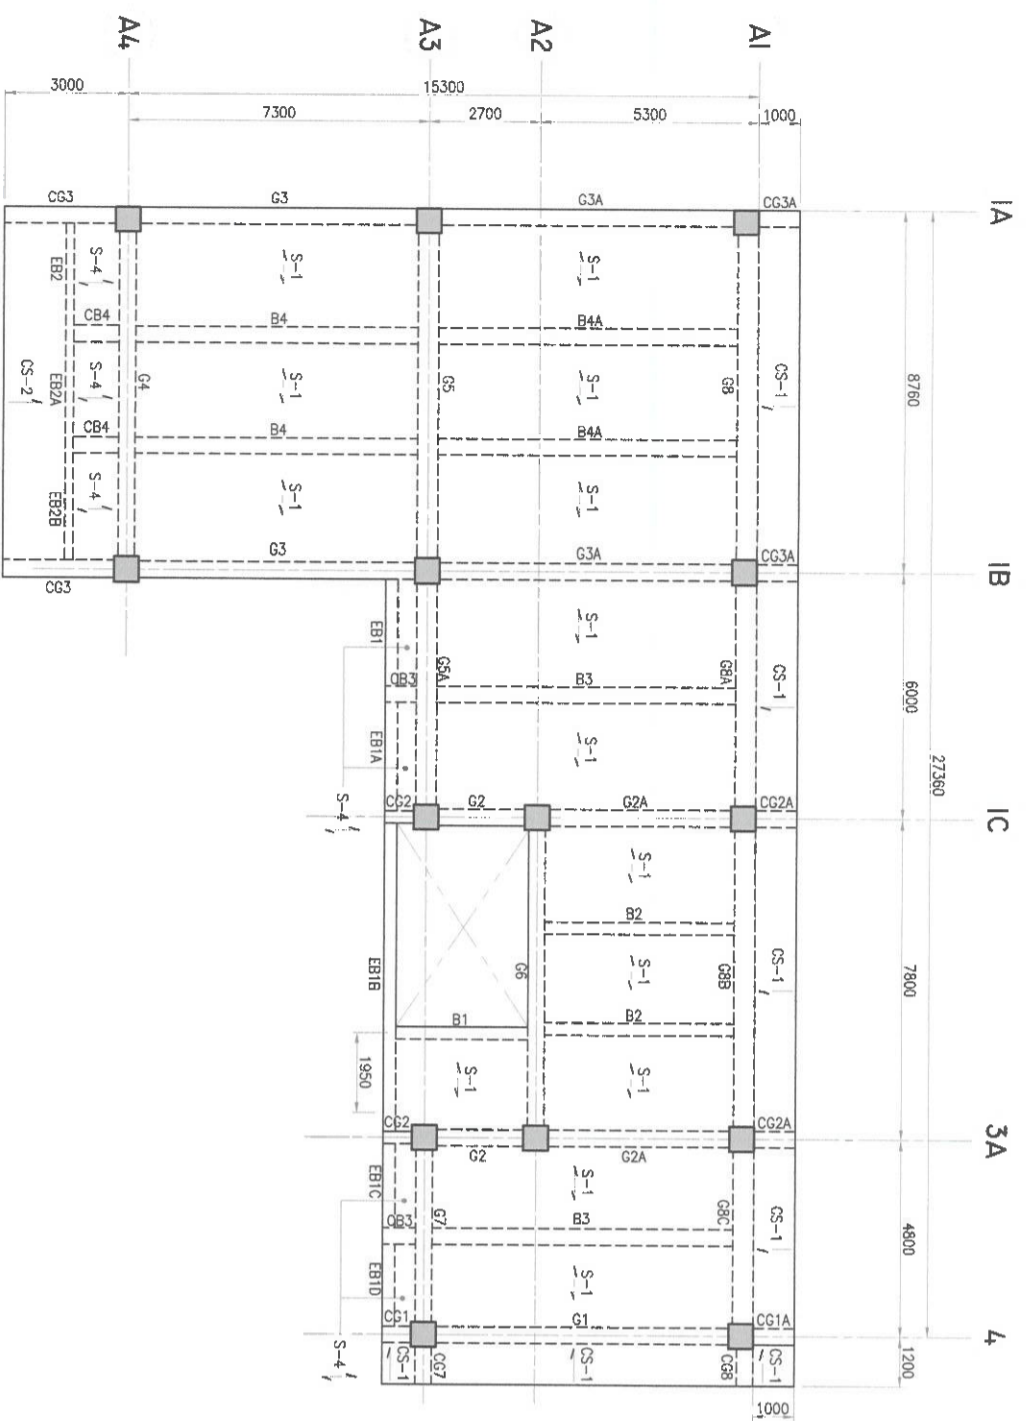

1 AS-BUILT UPPER FLOOR FRAMING PLAN  
SCALE 1:100M

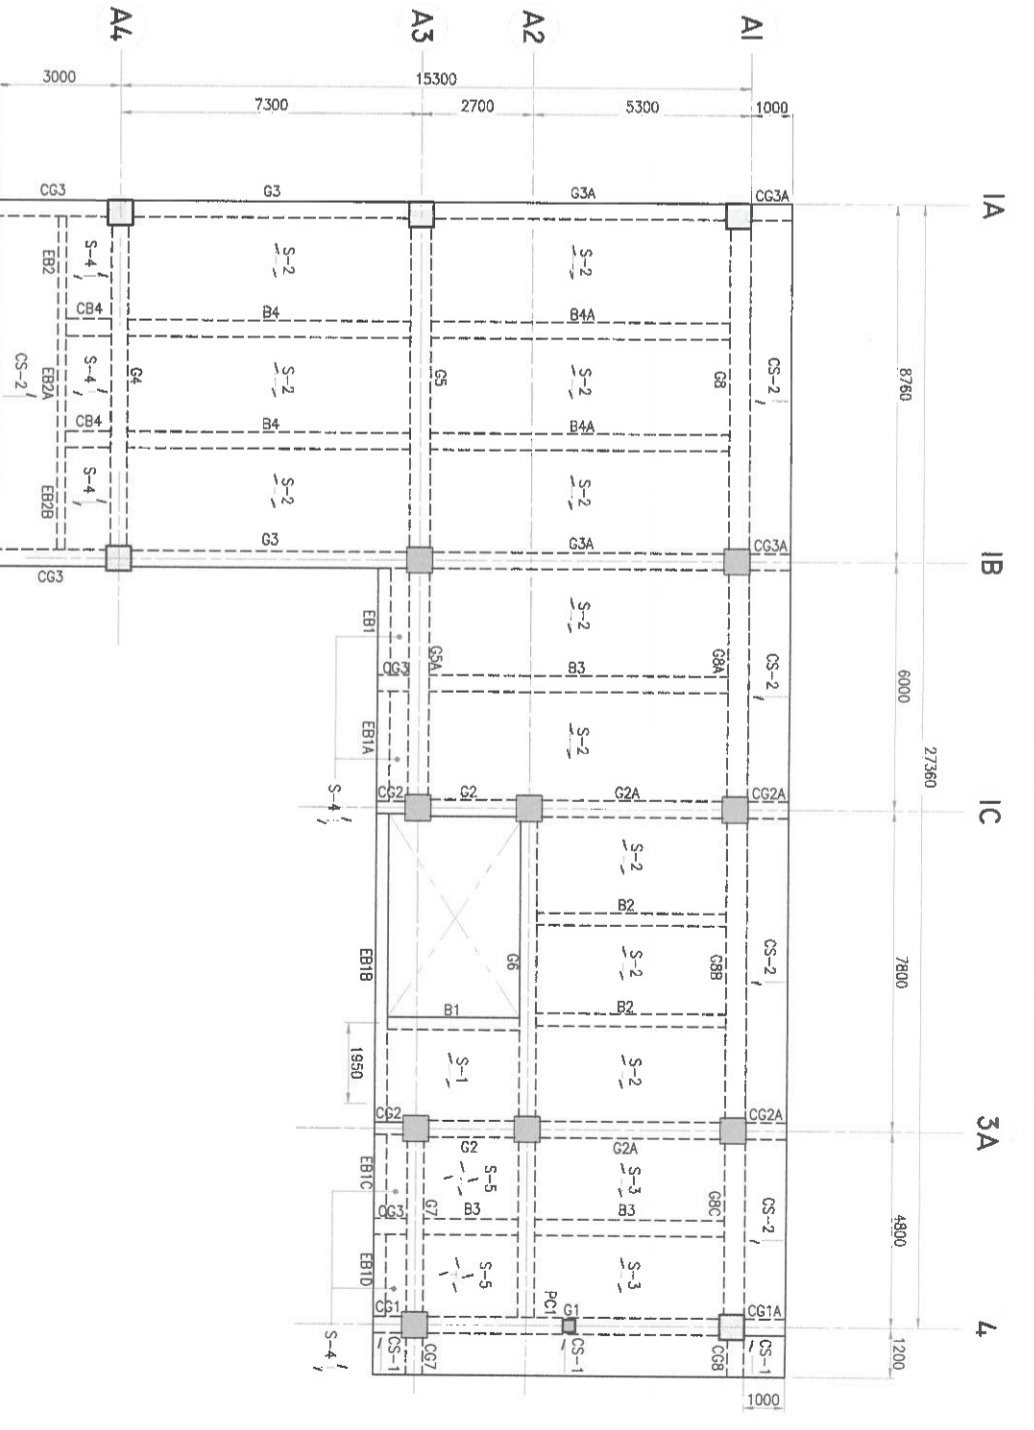

2 AS-BUILT ROOF DECK FRAMING PLAN  
SCALE 1:100M

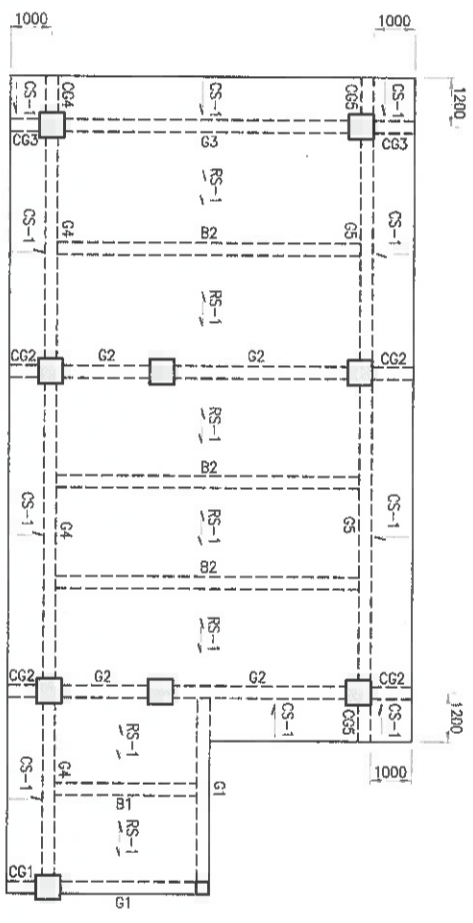

3 AS-BUILT ROOF FRAMING PLAN  
SCALE 1:100M

LEGEND:  
 CONTINUOUS COLUMN  
 TERMINATED COLUMN

NO.	DATE	REVISIONS	CHK.	DATE
0	OCT 2018			

DATE	NO.	REVISIONS	CHK.	DATE	PAPER SIZE	SHEET NO.
OCT 2018					20X30	S-002
OCT 2018					SCALE	PROJECT NO.
					AS SHOWN	SO-G-18-018

PREPARED BY

*Andres M. Alarcon*  
**ANDRES M. ALARCON**  
 ENGINEER

OWNER

**SOCIAL SECURITY SYSTEM (SSS)**  
 EAST AVENUE, DUMAY, QUEZON CITY

PROJECT TITLE/LOCATION

**STRUCTURAL ASSESSMENT OF SSS TARLAC BUILDING**  
 HEN LABRILLOS ST. TARLAC, TARLAC

SHEET CONTENTS

**SCHEDULE OF COLUMN SCHEDULE OF GIRDERS & SECONDARY BEAMS**

REMARKS: P.A. 9266 SEC. 33  
 REVISIONS TO SPECIFICATIONS AND CONTRACT DOCUMENTS FOR STRUCTURAL AND CIVIL ASSESSMENT OF SSS TARLAC BUILDING. THE ASSUMPTIONS FOR SERVICE ARE THE RESPONSIBILITY OF THE CLIENT FOR WHICH THE ENGINEER IS NOT RESPONSIBLE. THE ENGINEER HAS CONDUCTED VISUAL INSPECTION OF THE STRUCTURE AND HAS IDENTIFIED DEFECTS AND RECOMMENDED REPAIRS OR REPLACEMENTS OF DEFECTIVE MEMBERS. THE ENGINEER HAS NOT CONDUCTED LABORATORY TESTS OR OTHER SPECIAL INVESTIGATIONS. THE ENGINEER HAS NOT CONDUCTED FOUNDATION ASSESSMENT OR ANALYSIS OF SOIL CONDITIONS.

NO.	DATE	BY	APPROVED	DATE	NO.	REVISIONS	CHK	DATE	PAPER SIZE	SHEET NO.
0	OCT 2018	HME	MRB	OCT 2018					20X30	S-003
									SCALE	PROJECT NO.
									AS SHOWN	SO-G-18-018